

This is a addition to Cond # 11
Plot # 42.6 - Parcel # 0170
No. 120
Replaces plat 55-426-0170

COPY


CONDOMINIUM NUMBER 11

PIONEER VILLAGE CARRIAGE HOMES CONDOMINIUM

FIRST SUPPLEMENTAL FLOOR PLANS

SITE PLAN

These First Supplemental Floor Plans have been recorded as part of the Declaration filed as Document No. _____ on the _____ day of _____ A.D., 19____, Goodhue County Recorder.

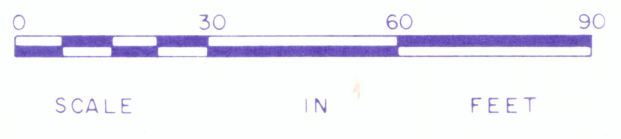


BENCHMARK: Top hydrant Pioneer Road and Village Drive
Elevation: 816.48 (N.G.V.D. 1929)

SCALE: 1 INCH = 30 FEET

○ Denotes 1/2 inch by 14 inch iron monument set
Marked with Reg. No. 8625 unless otherwise shown.

The west line of Lot 3, Block 2 is assumed to have a bearing of South 0 degrees 08 minutes 15 seconds East.

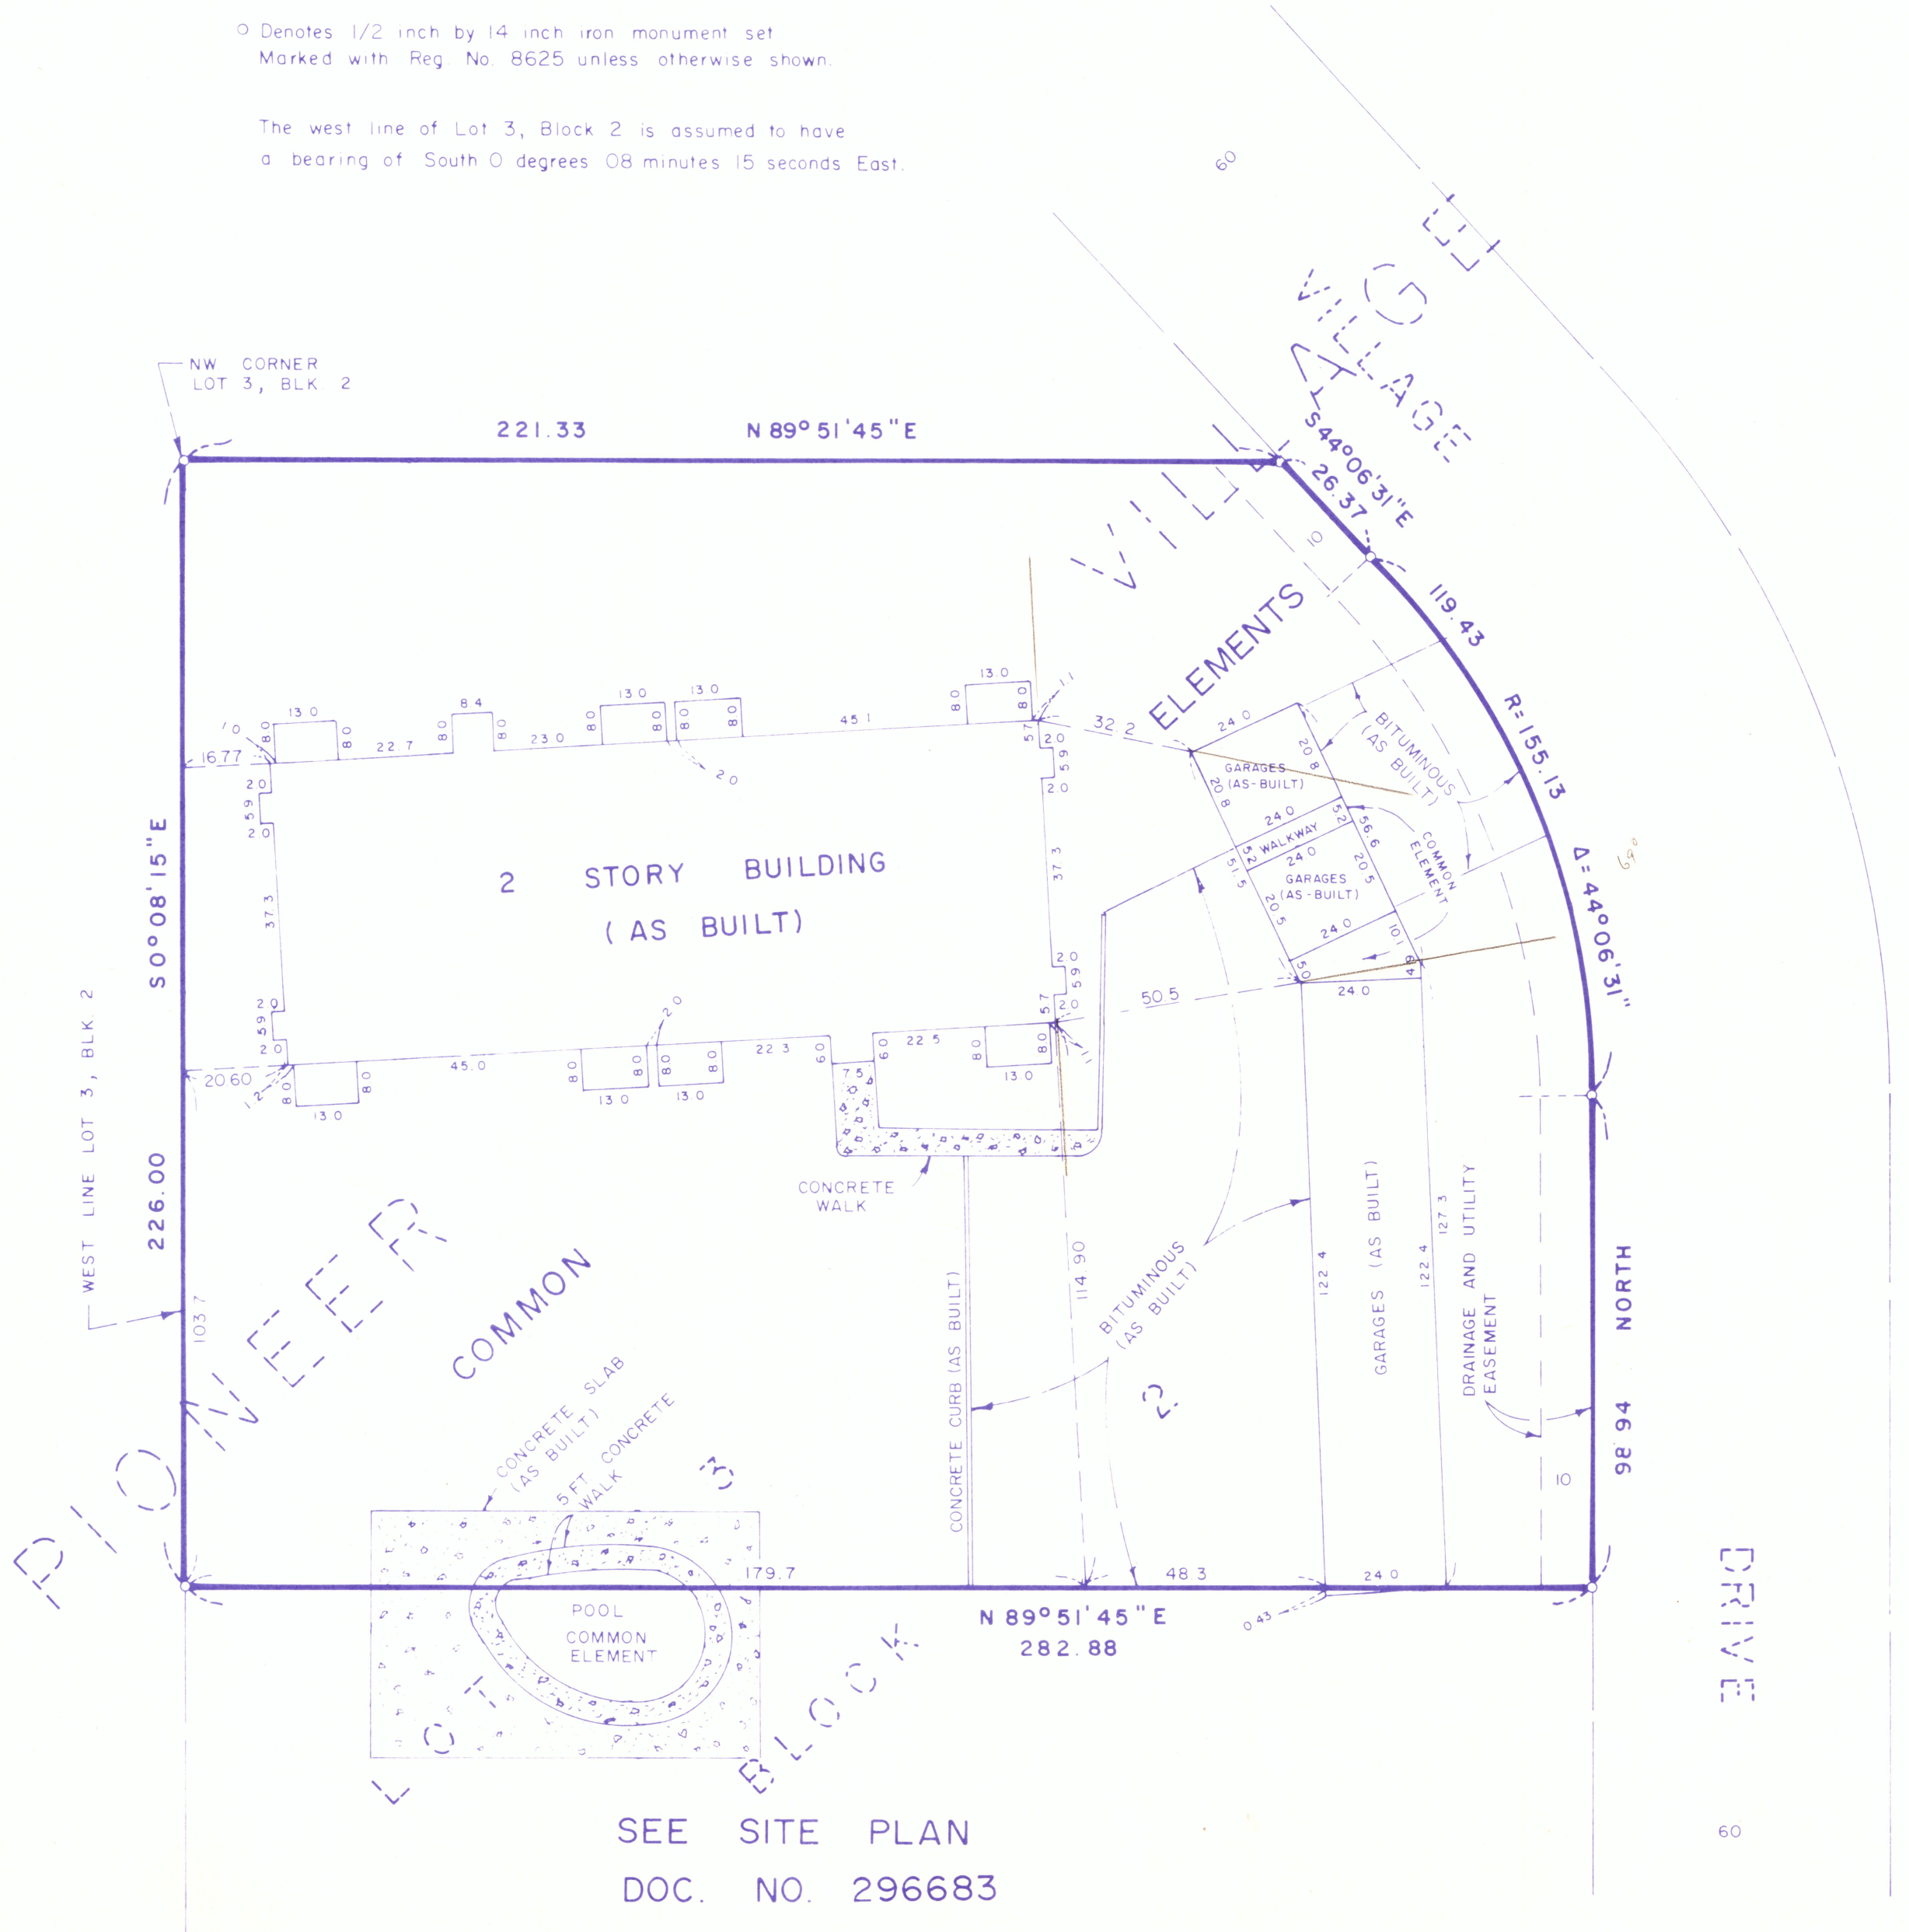

The undersigned, being first duly sworn under oath, certifies and deposes that these First Supplemental Floor Plans of Condominium Number 11, Pioneer Village Carriage Homes Condominium, being located upon:

That part of Lot 3, Block 2, PIONEER VILLAGE, according to the recorded plat thereof, Goodhue County, Minnesota, lying north of the following described line: Commencing at the northwest corner of said Lot 3; thence South 0 degrees 08 minutes 15 seconds East (assumed bearing) along the west line of said Lot 3 a distance of 226.00 feet to the point of beginning of the line to be described; thence North 89 degrees 51 minutes 45 seconds East a distance of 282.88 feet to the east line of said Lot 3 and said line there terminating.

fully and accurately depicts all information required by Minnesota Statutes Section 515A.2-110.

Dated this 11th day of August, 1986.

Delmar H. Schwanz
Delmar H. Schwanz, Registered Land Surveyor
Minnesota Registration Number 8625

State of Minnesota
County of Dakota
The foregoing instrument was acknowledged before me this 11th day of August, 1986, by Delmar H. Schwanz, a registered professional land surveyor.

Gregory J. Johnson
Notary Public

Mark R. McKechnie, a registered professional architect for the State of Minnesota pursuant to Minnesota Statutes Section 515A.2-101(b) does hereby certify that all structural components and mechanical systems serving more than one unit of all buildings containing or comprising any units hereby created are substantially completed consistent with the First Supplemental Floor Plans for Condominium Number 11, Pioneer Village Carriage Homes Condominium.

Dated this 11th day of August, 1986.

Mark R. McKechnie
Mark R. McKechnie, Registered Architect
Minnesota Registration Number 13033


State of Minnesota
County of Goodhue
The foregoing instrument was acknowledged before me this 11th day of August, 1986, by Mark R. McKechnie, a professional architect.

Harold M. Bragdon
Notary Public


DELMAR H. SCHWANZ
LAND SURVEYORS INC.

CONDOMINIUM NUMBER 11


PIONEER VILLAGE CARRIAGE HOMES CONDOMINIUM FIRST SUPPLEMENTAL FLOOR PLANS

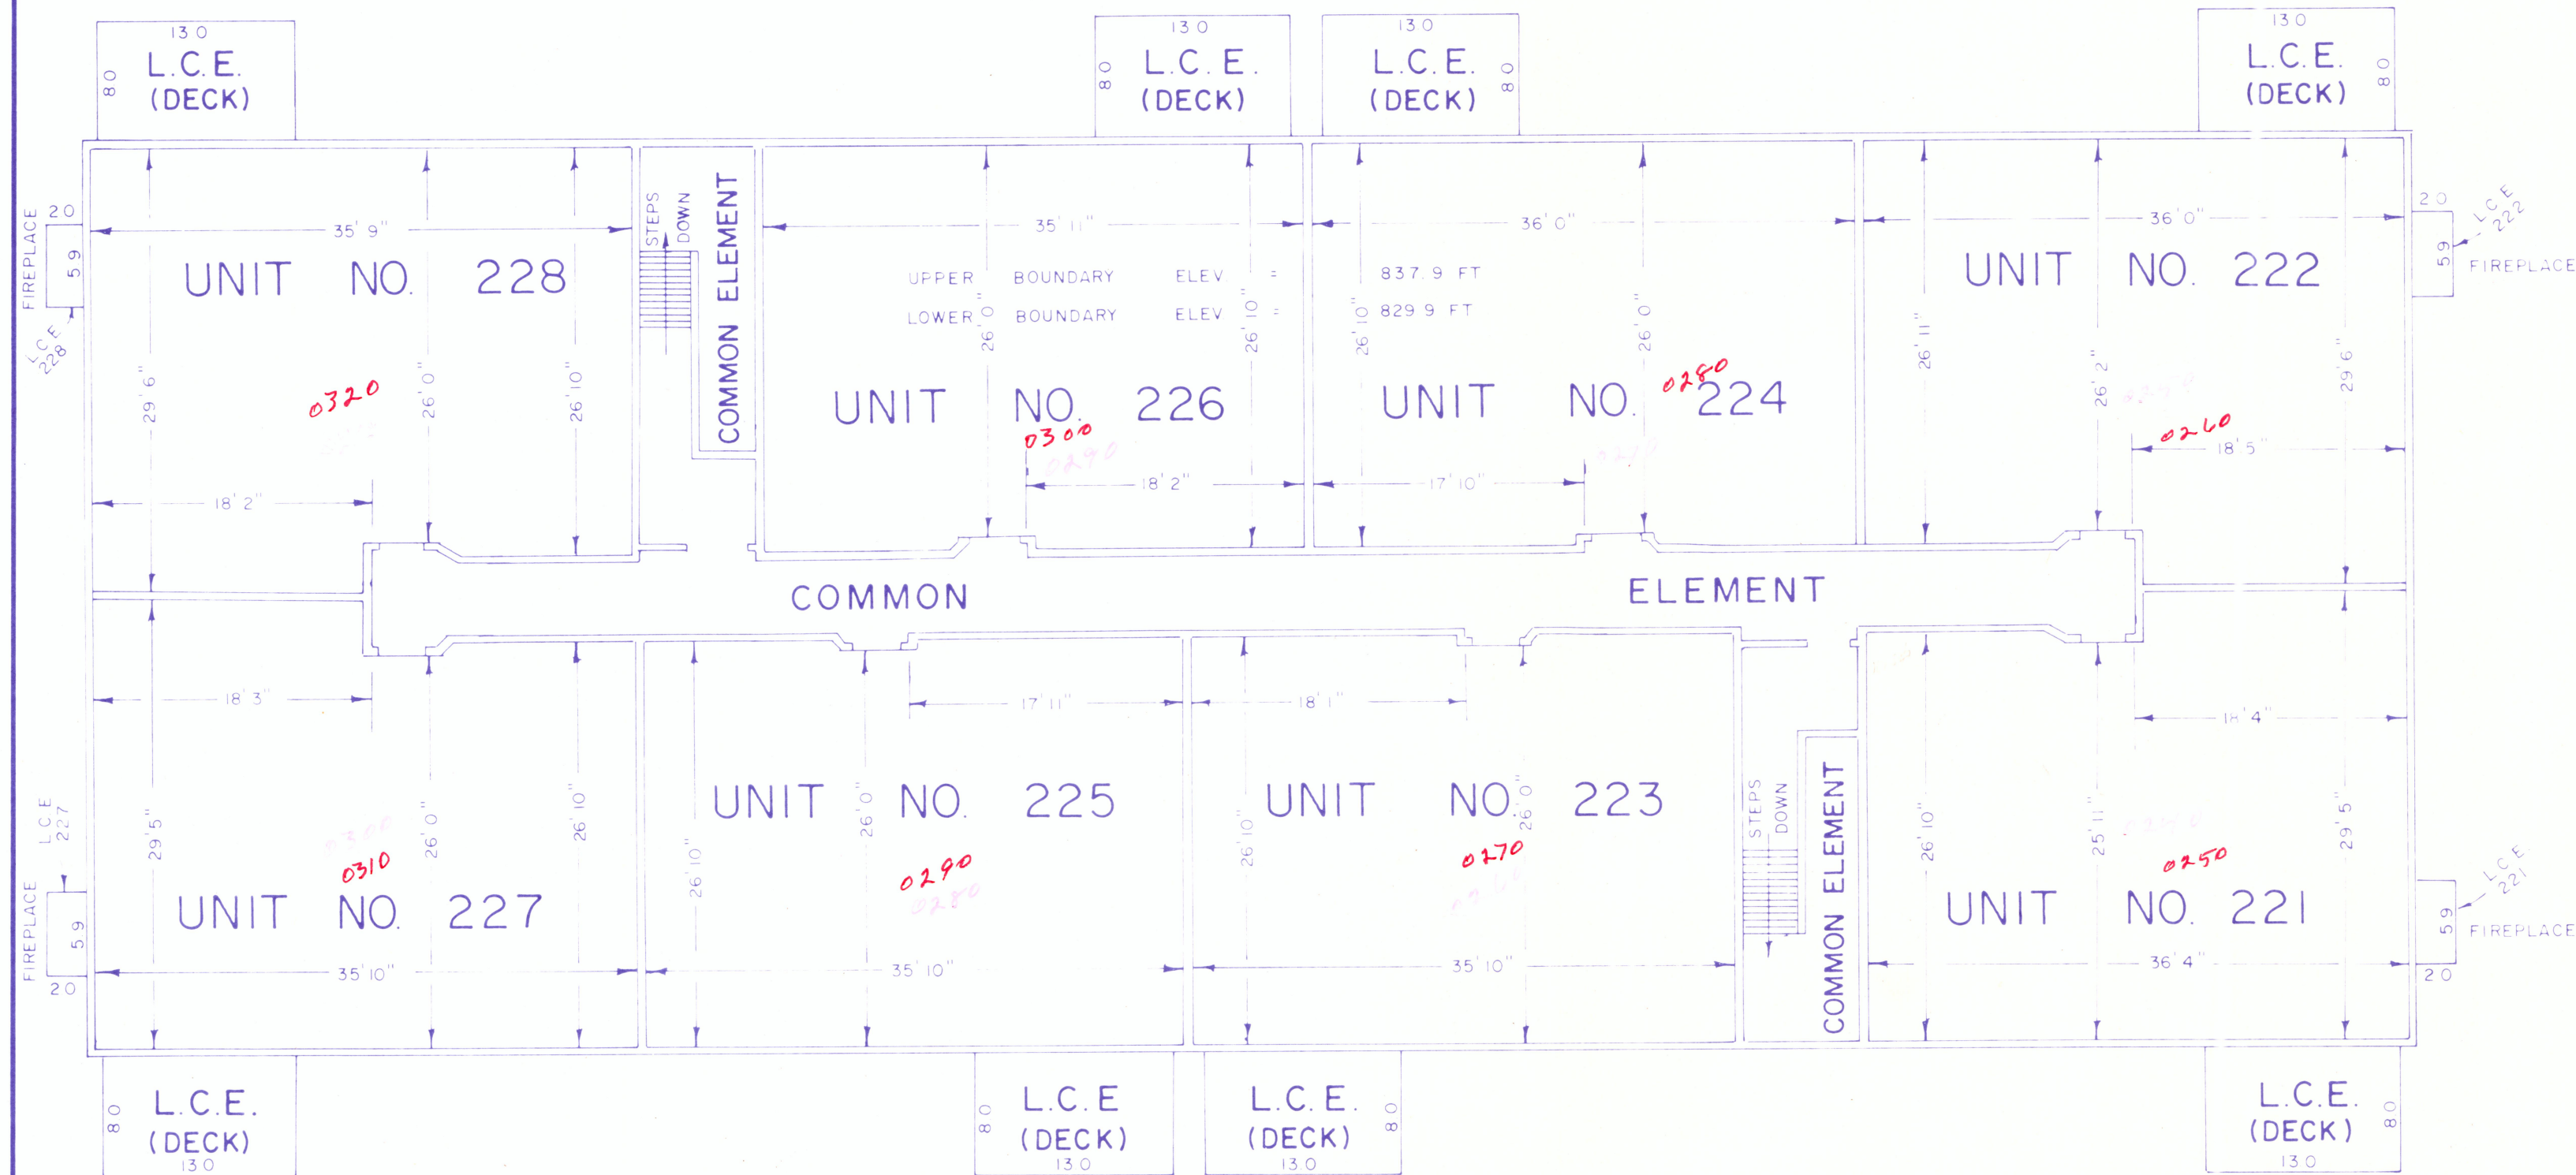

UPPER LEVEL FLOOR PLAN (AS BUILT)

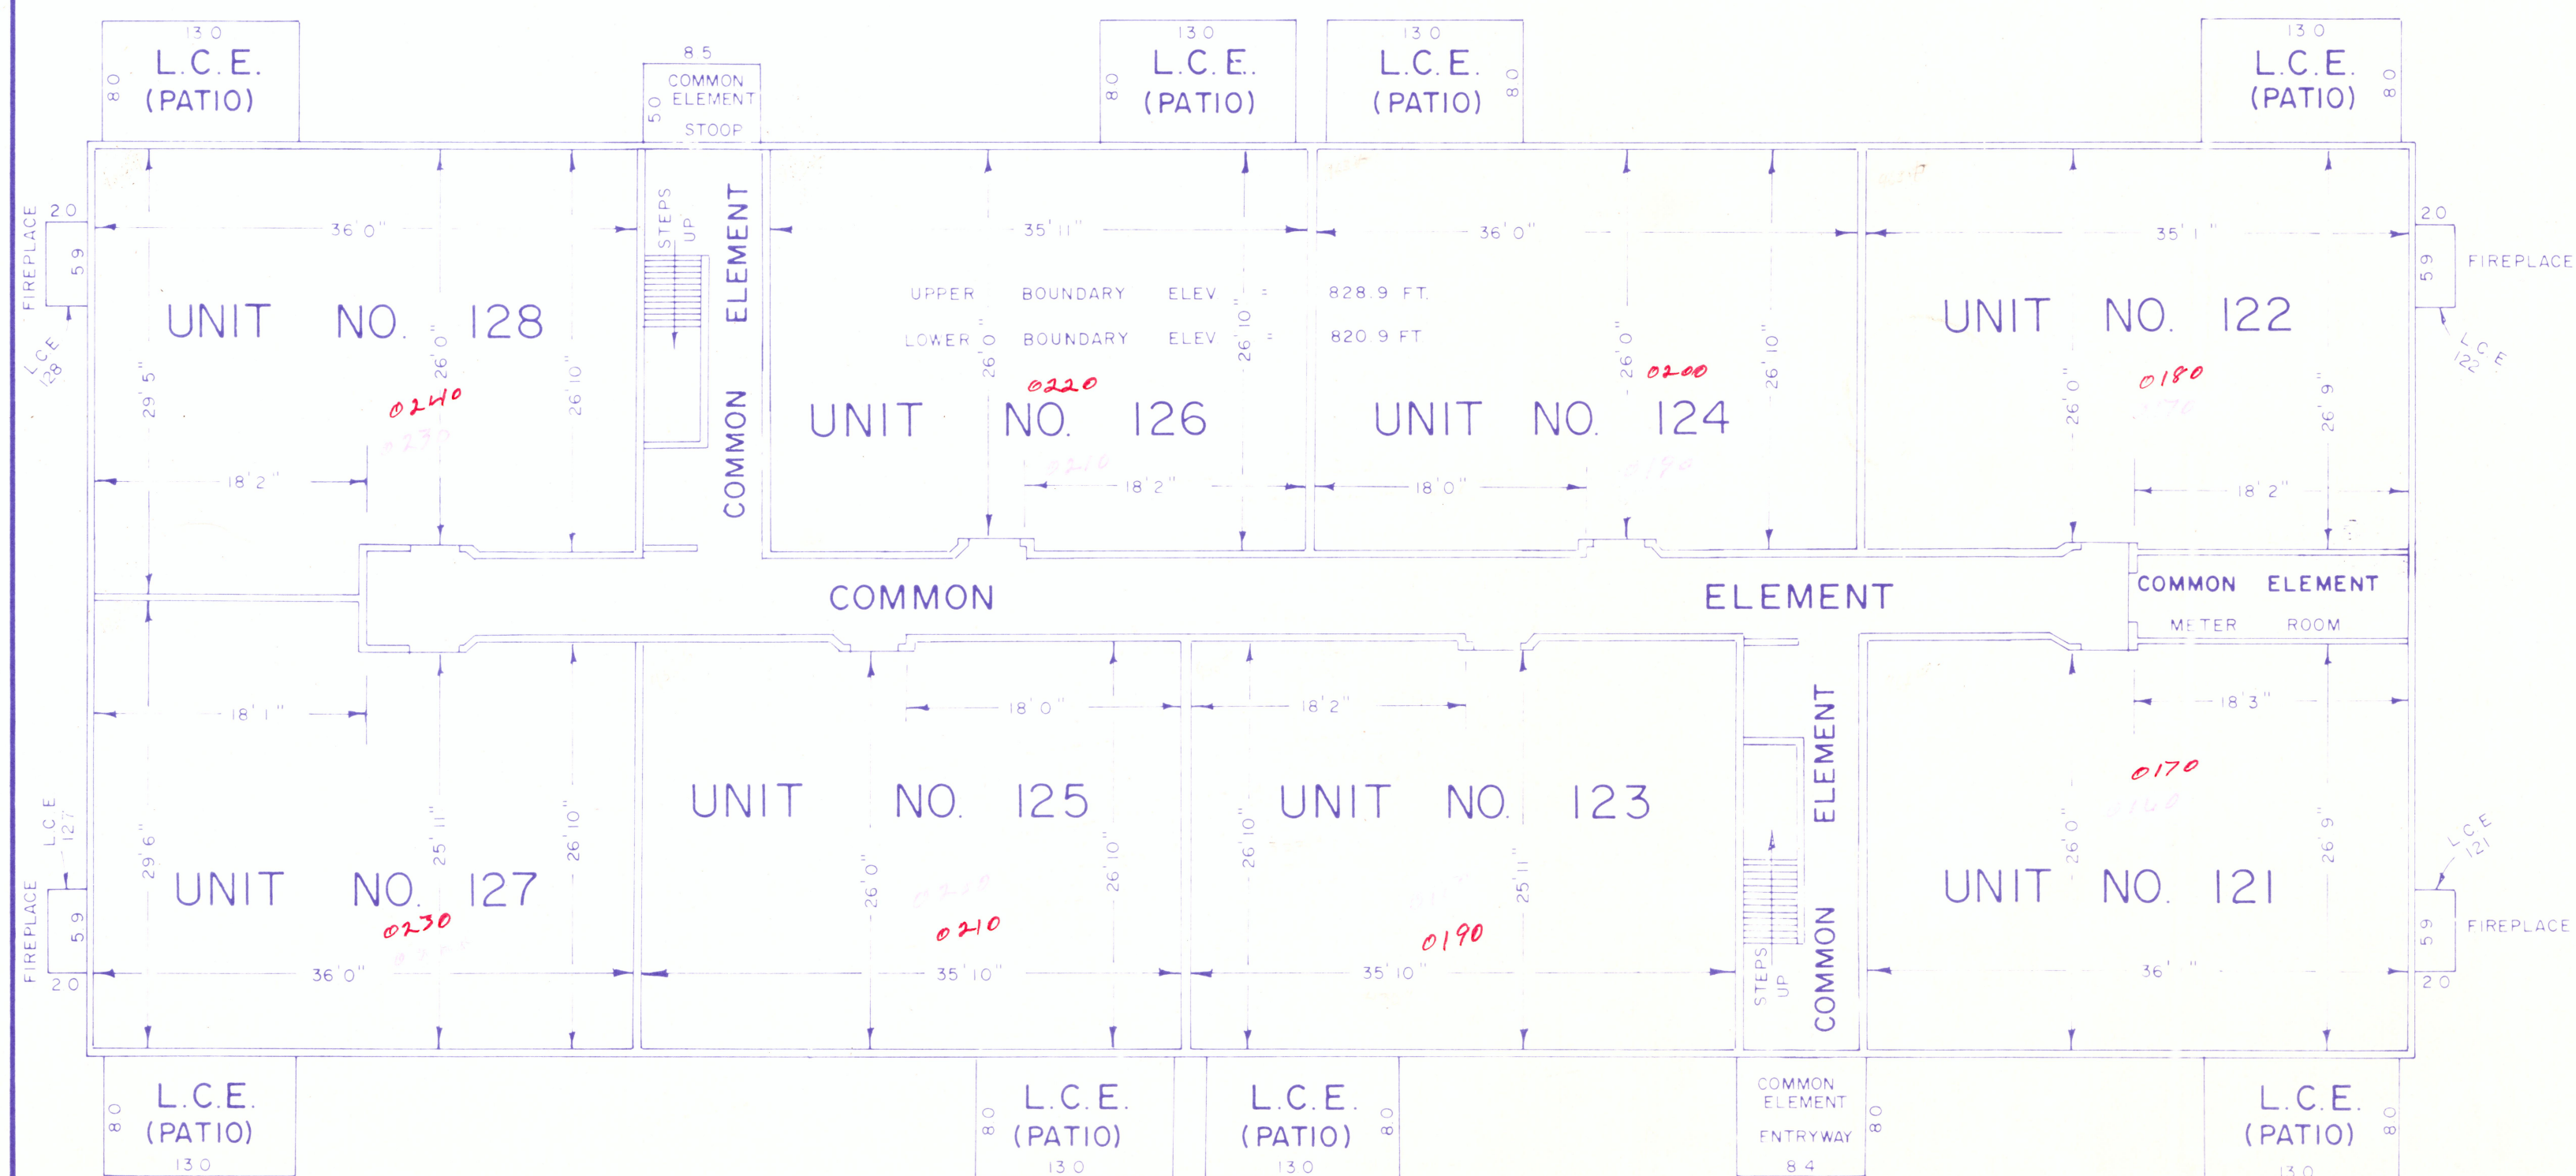


LOWER LEVEL FLOOR PLAN (AS BUILT)

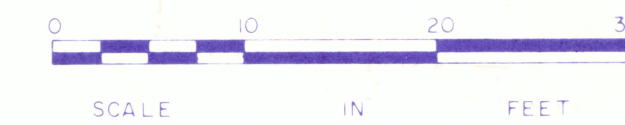


SCALE 1 INCH = 10 FEET

L.C.E. DENOTES LIMITED COMMON ELEMENT

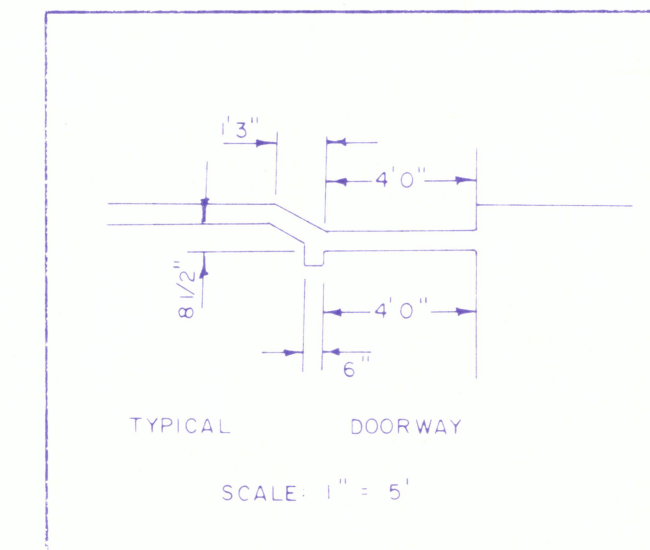

GARAGES (AS BUILT)

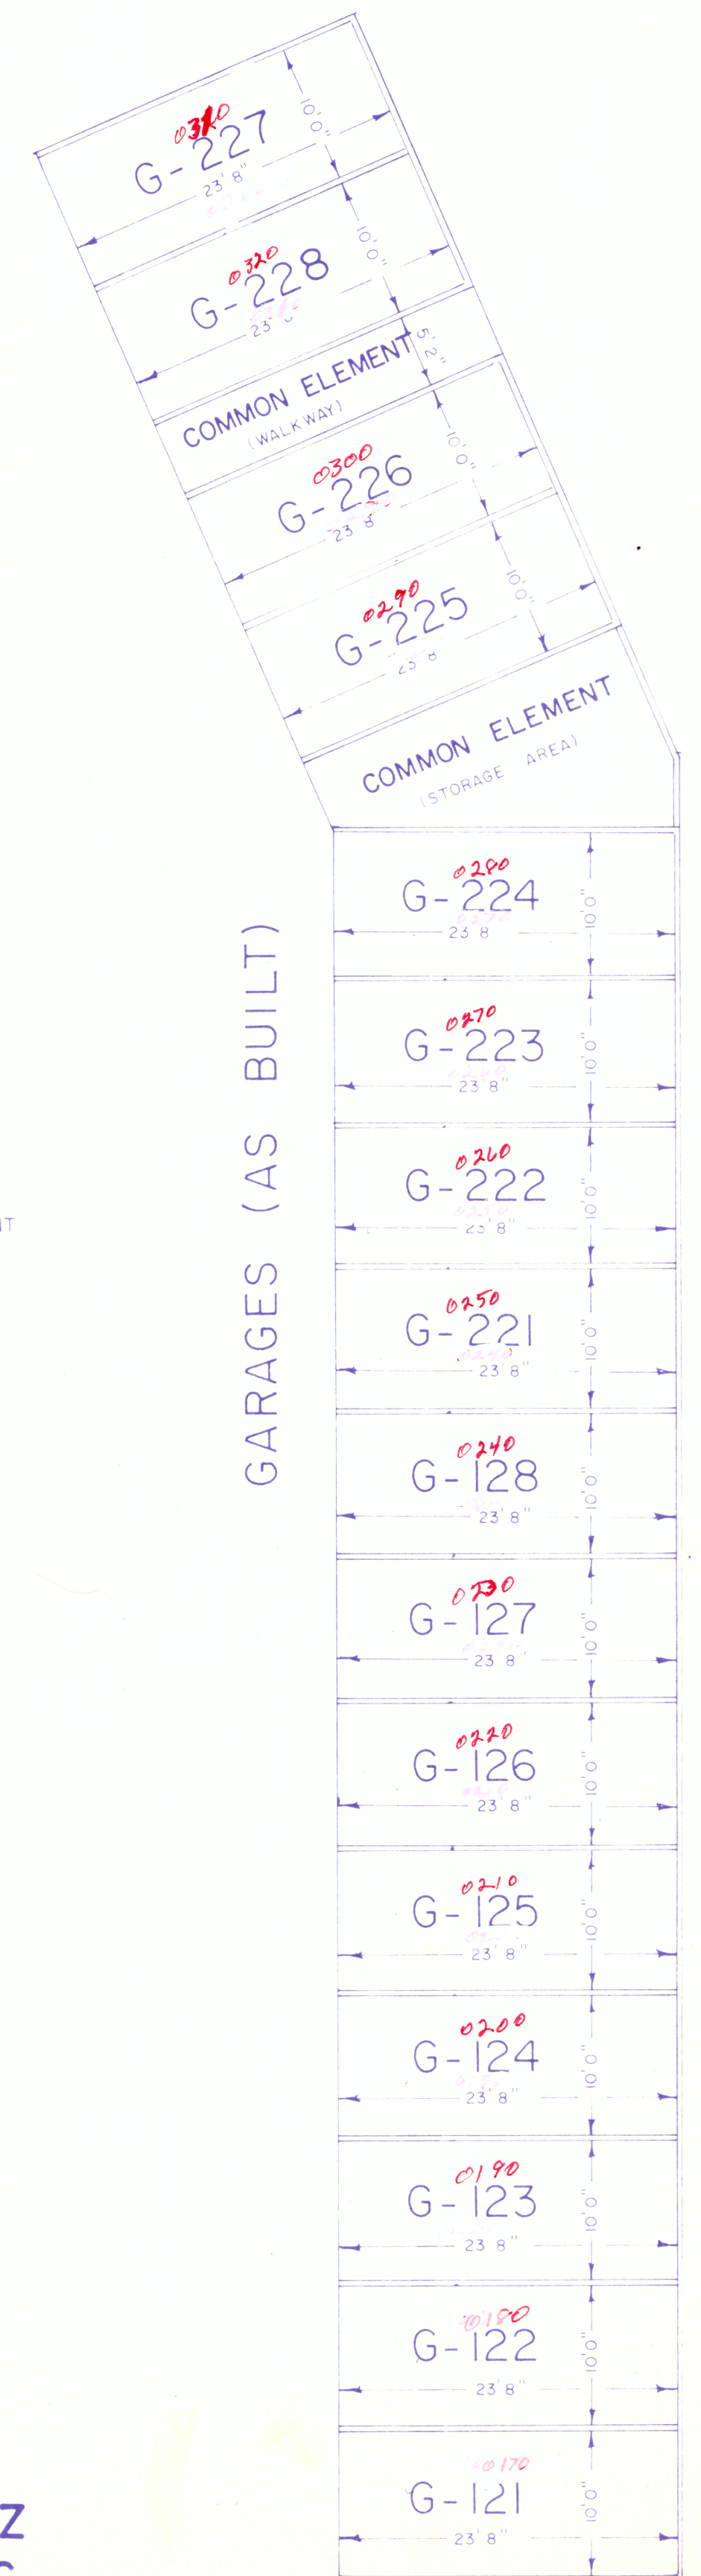

DELMAR H. SCHWANZ
LAND SURVEYORS INC.